








 
 





 


PSM204913  
 E: 505792.285  
 N: 7041641.909  
 RL: 11.093m



UIL 12.166  
 DIL 11.952  
 #1350  
 45.452m

BOTANTIC AVENUE

**LEGEND**


-  END STRUCTURE
-  LIP-IN-LINE GULLY PIT
-  FIELD INLET
-  MAINTENANCE HOLE
-  DRAINAGE PIPE
-  BARRIER KERB AND CHANNEL - B1
-  BARRIER KERB - B6
-  BARRIER KERB - B2
-  MOUNTABLE KERB AND CHANNEL - M1
-  MOUNTABLE KERB - M5
-  SEMI-MOUNTABLE KERB - SM3
-  INVERT CHANNEL - INV900
-  REMOVABLE BOLLARD
-  SEDIMENT FOREBAY
-  TRAFFIC SIGN



**ENGINEER'S CERTIFICATION**  
 I, \_\_\_\_\_, hereby certify that the as constructed details shown on this drawing are a true and accurate record of the construction works, in compliance with the contract documents, approved drawings and approved design.  
 RPEQ (signature) RPEQ No. \_\_\_\_\_ Date: \_\_\_\_\_

**REGISTERED SURVEYOR'S CERTIFICATION**  
 I, \_\_\_\_\_, hereby certify that the vertical and horizontal locations and dimensions shown on this plan are a true and correct record and were located by survey.  
 Registered Surveyor (sig) Reg. Surveyor No. \_\_\_\_\_ Date: \_\_\_\_\_

**COORDINATE DATUM NOTE:**  
 HORIZONTAL COORDINATES(E,N) SUPPLIED ARE MAPPING GRID OF AUSTRALIA(MGA), ZONE 56 BASED ON THE UNIVERSAL TRANSVERSE MERCATOR PROJECTION AND THE GEOCENTRIC DATUM OF AUSTRALIA 2020.

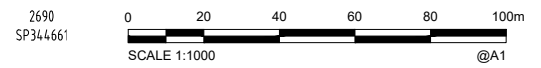

**AS CONSTRUCTED**

<b>A1</b>	0	31/07/2025	AS CONSTRUCTED DETAILS	AP	EC	
	INDEX	DATE	REVISIONS	DRAWN	CHECKED	PASSED


DRAWN	AP	31/07/2025
CHECKED	EC	31/07/2025
PASSED		
INITIALS		DATE



SUNSHINE COAST COUNCIL  
 SSC-15000256-ADAC  
 HARMONY RELEASE 25  
 AS CONSTRUCTED  
 ROADS AND DRAINAGE

SHEET 2 OF 4 SHEETS	SCALE
REVISION DATE 31/07/2025	REVISION 0
DISCIPLINE CODE	
DRAWING NO. SSC-15000256-ADAC-1	

PSM204913  
 E: 505792.285  
 N: 7041641.909  
 RL: 11.093m

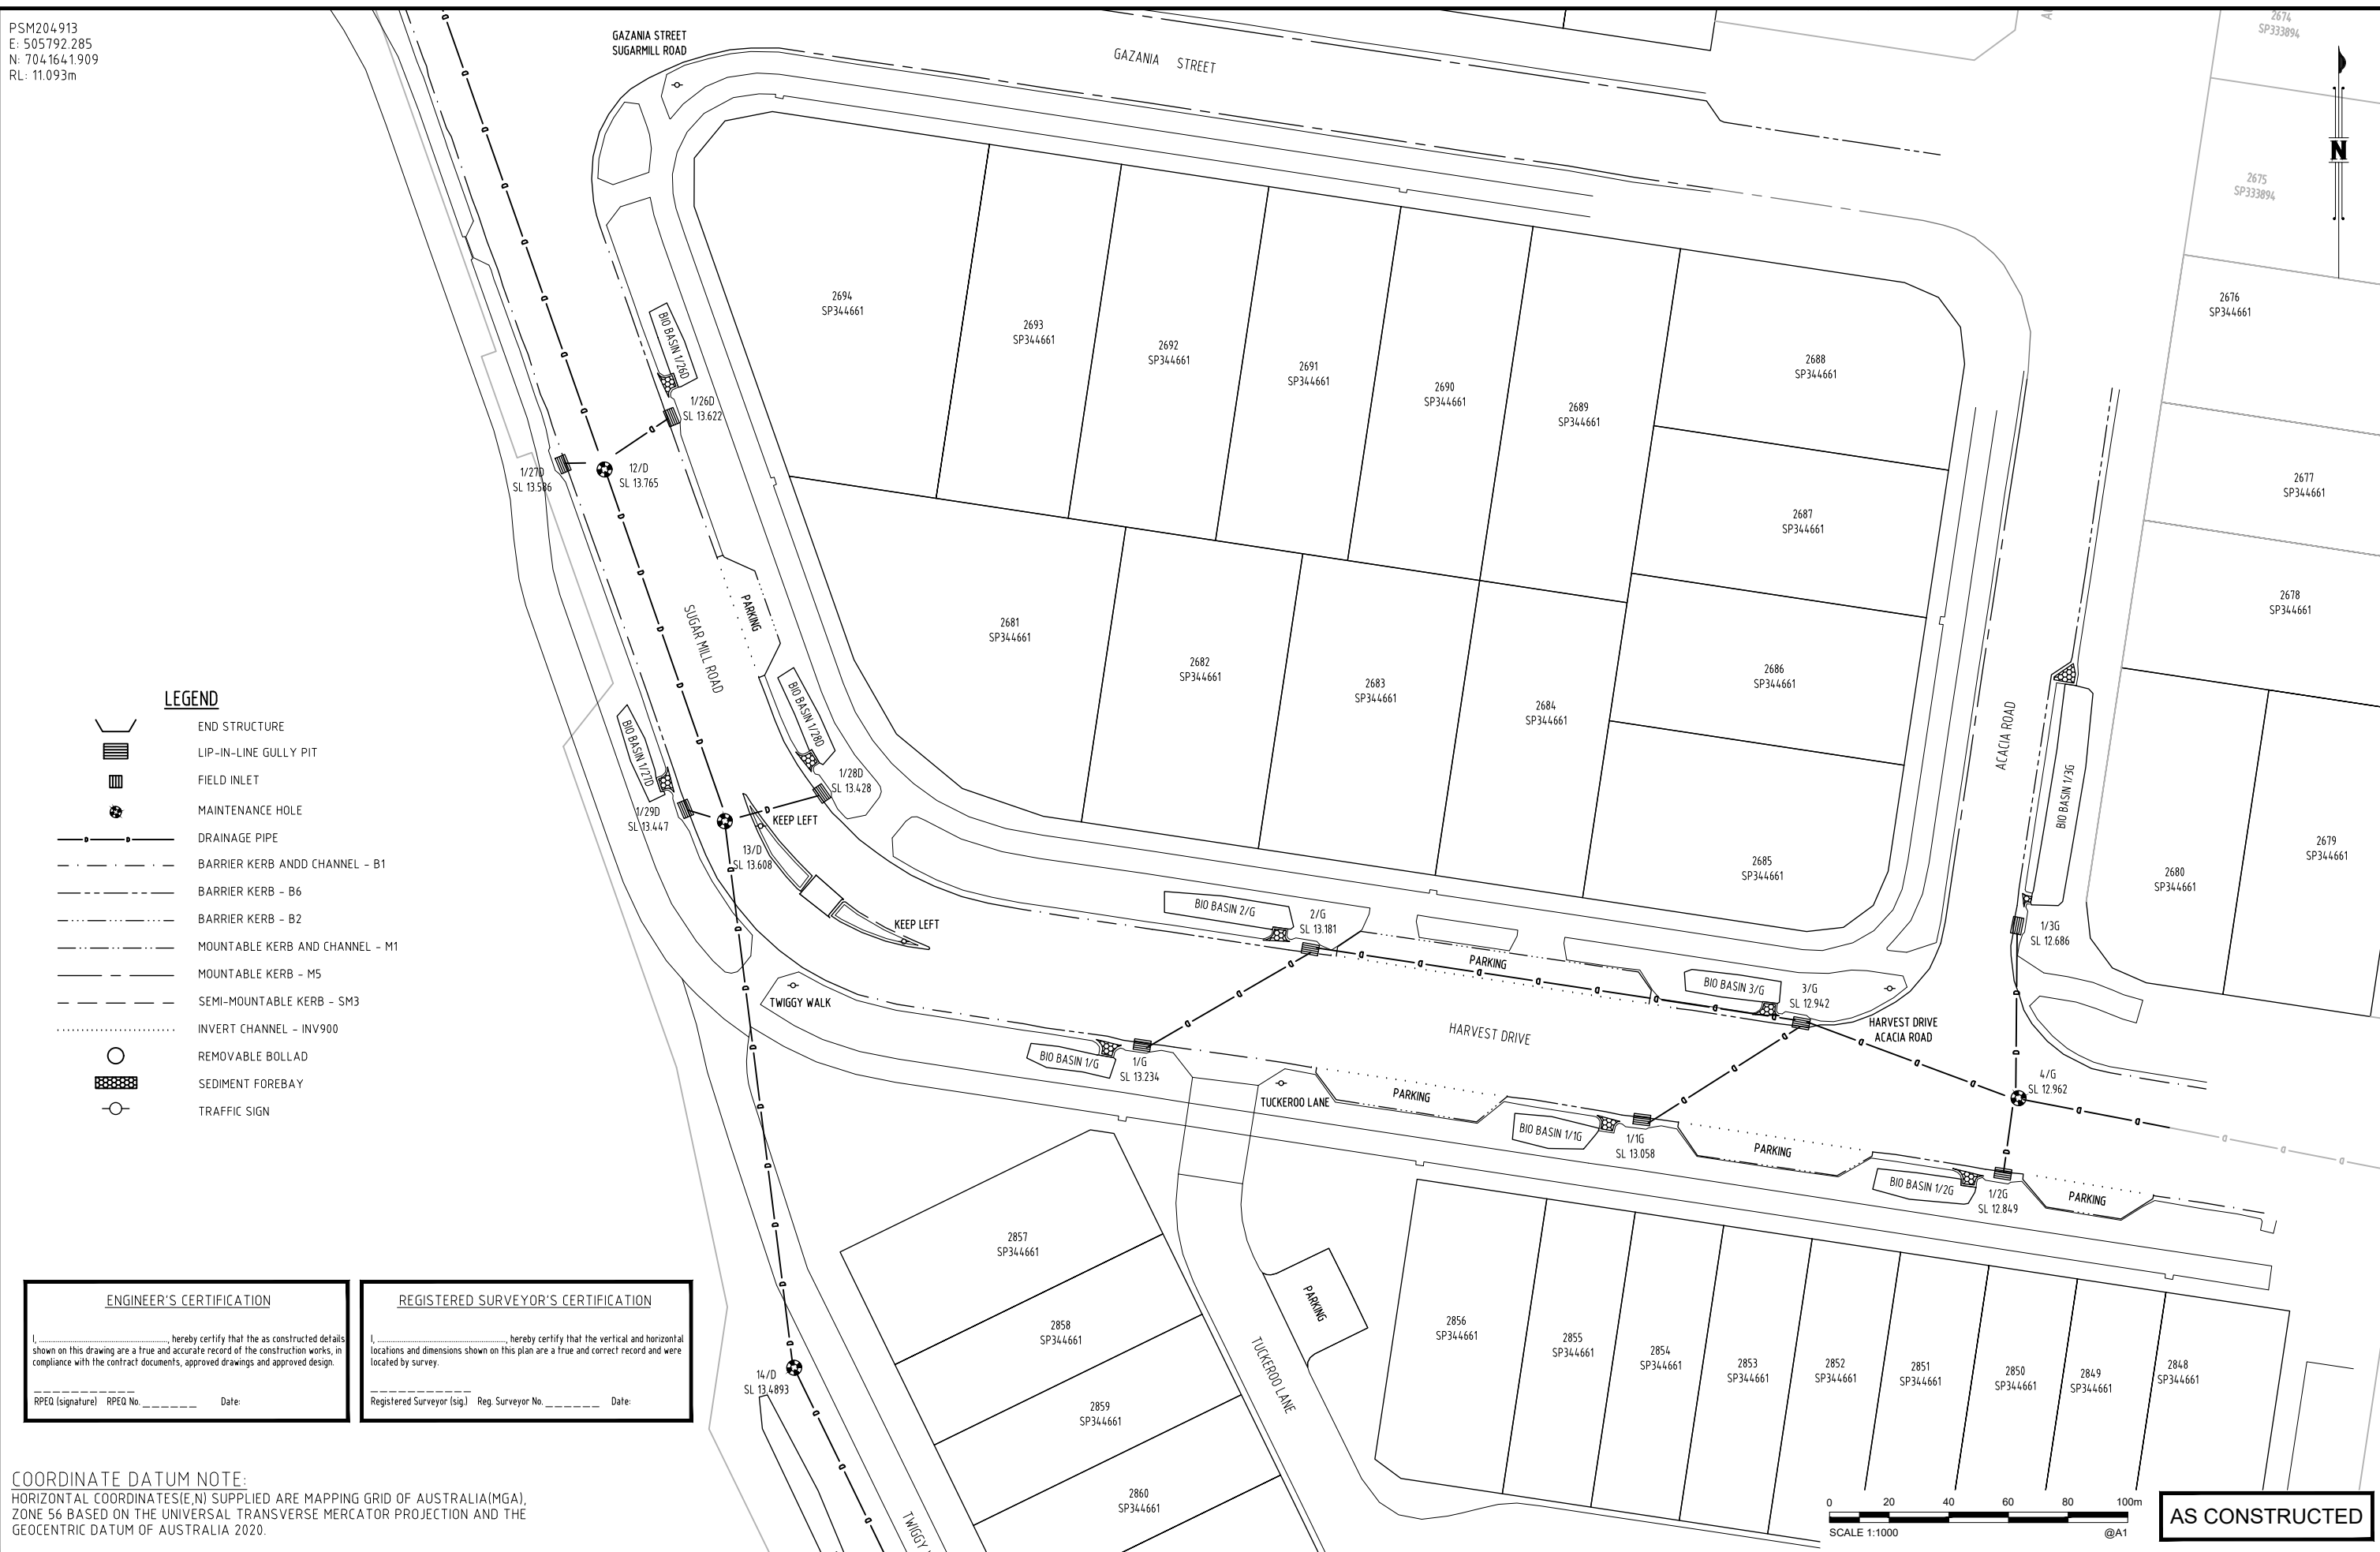


**LEGEND**

- END STRUCTURE
- LIP-IN-LINE GULLY PIT
- FIELD INLET
- MAINTENANCE HOLE
- DRAINAGE PIPE
- BARRIER KERB AND CHANNEL - B1
- BARRIER KERB - B6
- BARRIER KERB - B2
- MOUNTABLE KERB AND CHANNEL - M1
- MOUNTABLE KERB - M5
- SEMI-MOUNTABLE KERB - SM3
- INVERT CHANNEL - INV900
- REMOVABLE BOLLARD
- SEDIMENT FOREBAY
- TRAFFIC SIGN

**ENGINEER'S CERTIFICATION**  
 I, \_\_\_\_\_, hereby certify that the as constructed details shown on this drawing are a true and accurate record of the construction works, in compliance with the contract documents, approved drawings and approved design.  
 RPEQ (signature) RPEQ No. \_\_\_\_\_ Date: \_\_\_\_\_

**REGISTERED SURVEYOR'S CERTIFICATION**  
 I, \_\_\_\_\_, hereby certify that the vertical and horizontal locations and dimensions shown on this plan are a true and correct record and were located by survey.  
 Registered Surveyor (sig) Reg. Surveyor No. \_\_\_\_\_ Date: \_\_\_\_\_

**COORDINATE DATUM NOTE:**  
 HORIZONTAL COORDINATES(E,N) SUPPLIED ARE MAPPING GRID OF AUSTRALIA(MGA), ZONE 56 BASED ON THE UNIVERSAL TRANSVERSE MERCATOR PROJECTION AND THE GEOCENTRIC DATUM OF AUSTRALIA 2020.

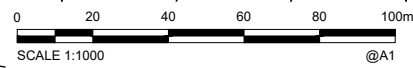

**AS CONSTRUCTED**

A1	0	31/07/2025	AS CONSTRUCTED DETAILS	AP	EC				
	INDEX	DATE	REVISIONS	DRAWN	CHECKED	PASSED	INITIALS	DATE	

DRAWN	AP	31/07/2025
CHECKED	EC	31/07/2025
PASSED		

EGIS CONSULTING Pty Ltd  
 Level 4, Unit 401, 8 Market Lane,  
 Maroochydore, QLD 4558  
 Telephone 07 5314 2520  
 Facsimile 07 5314 2522

Sunshine Coast COUNCIL

SUNSHINE COAST COUNCIL  
 SSC-15000256-ADAC  
 HARMONY RELEASE 25  
 AS CONSTRUCTED  
 ROADS AND DRAINAGE

SHEET 2 OF 4 SHEETS	SCALE
REVISION DATE 31/07/2025	REVISION (0)
DISCIPLINE CODE	
DRAWING NO. SSC-15000256-ADAC-2	


PSM204913  
 E: 505792.285  
 N: 7041641.909  
 RL: 11.093m



**ENGINEER'S CERTIFICATION**  
 I, \_\_\_\_\_, hereby certify that the as constructed details shown on this drawing are a true and accurate record of the construction works, in compliance with the contract documents, approved drawings and approved design.  
 RPEQ (signature) RPEQ No. \_\_\_\_\_ Date: \_\_\_\_\_

**REGISTERED SURVEYOR'S CERTIFICATION**  
 I, \_\_\_\_\_, hereby certify that the vertical and horizontal locations and dimensions shown on this plan are a true and correct record and were located by survey.  
 Registered Surveyor (sig) Reg. Surveyor No. \_\_\_\_\_ Date: \_\_\_\_\_

**COORDINATE DATUM NOTE:**  
 HORIZONTAL COORDINATES(E,N) SUPPLIED ARE MAPPING GRID OF AUSTRALIA(MGA), ZONE 56 BASED ON THE UNIVERSAL TRANSVERSE MERCATOR PROJECTION AND THE GEOCENTRIC DATUM OF AUSTRALIA 2020.

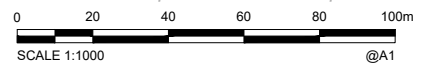

**AS CONSTRUCTED**

<b>A1</b>	0	31/07/2025	AS CONSTRUCTED DETAILS	AP	EC			
	INDEX	DATE	REVISIONS	DRAWN	CHECKED	PASSED	INITIALS	DATE

DRAWN	AP	31/07/2025
CHECKED	EC	31/07/2025
PASSED		



SUNSHINE COAST COUNCIL  
 SSC-15000256-ADAC  
 HARMONY RELEASE 25  
 AS CONSTRUCTED  
 ROADS AND DRAINAGE

SHEET 4 OF 4	SHEETS	SCALE
REVISION DATE	31/07/2025	REVISION (0)
DISCIPLINE CODE		
DRAWING NO.	SSC-15000256-ADAC-4	